

REV	REVISION NOTE	DATE
AB	AS BUILT	17.09.08
D	CABLE, CONNECTOR DETAILS ADDED	08.09.08
C	EXTRON MPS112 REPLACED KRAMER VP23C	05.09.08
B	DWG MOD, SAMSUNG REPLACED DENON	08.08.08
A	ADDED LAN CONNECTIONS, CHANGED AMP	01.08.08
-	FIRST DRAWN	16.07.08



ISSUE REASON:  
**AS BUILT**

**asysco**  
integrated audiovisual solutions

Asysco House, Omega Way  
Surrey TW20 8RD  
Tel: (01784) 487000 Fax: (01784) 487060

PROJECT:	SUFFOLK UNIVERSITY		
AREA:	CLASSROOM 60-80 SEATS		
TITLE:	VIDEO AUDIO CONTROL SCHEMATIC		
DRAWING NUMBER:	D2900-0236		
SALES SEQ NUMBER:	PROJECT DESIGN NUMBER:		
	D2900		
SCALE: NT5	ALL DIMENSIONS IN mm UNLESS OTHERWISE STATED		
CHECKED: MB	APPROVED: HC	DRAWN BY: AB	REV:

EQUIPMENT RACK INFORMATION	
MAKE	TEAMMATE
MODEL	TUTOR 14X500
RACK TOP	
RACK SIDES	
CASTORS	
CABLE TYPES	ASYSKO STANDARD
RACK > RACK	
RACK > SITE	2m TAILS - FEMALE CONNECTORS

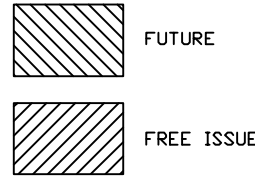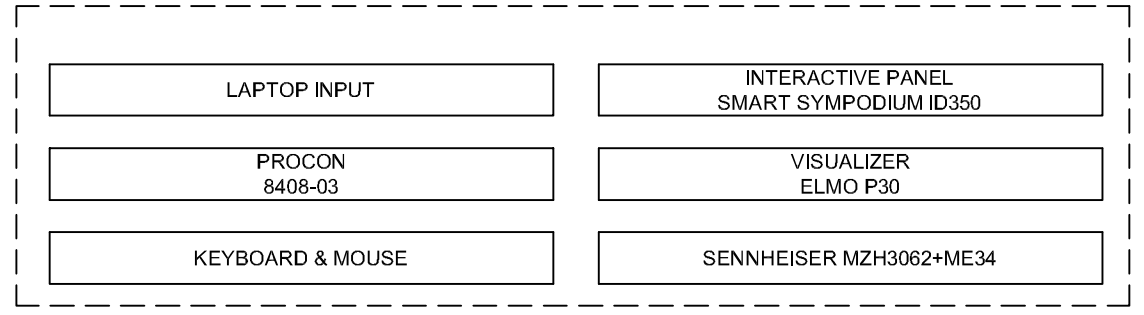

U:\PROJECT DESIGNS\SUFFOLK UNIDESIGN2 - CLASSROOM 60-80 SEATS D2900-0236.dwg