


# DIGITAL SIGNAGE

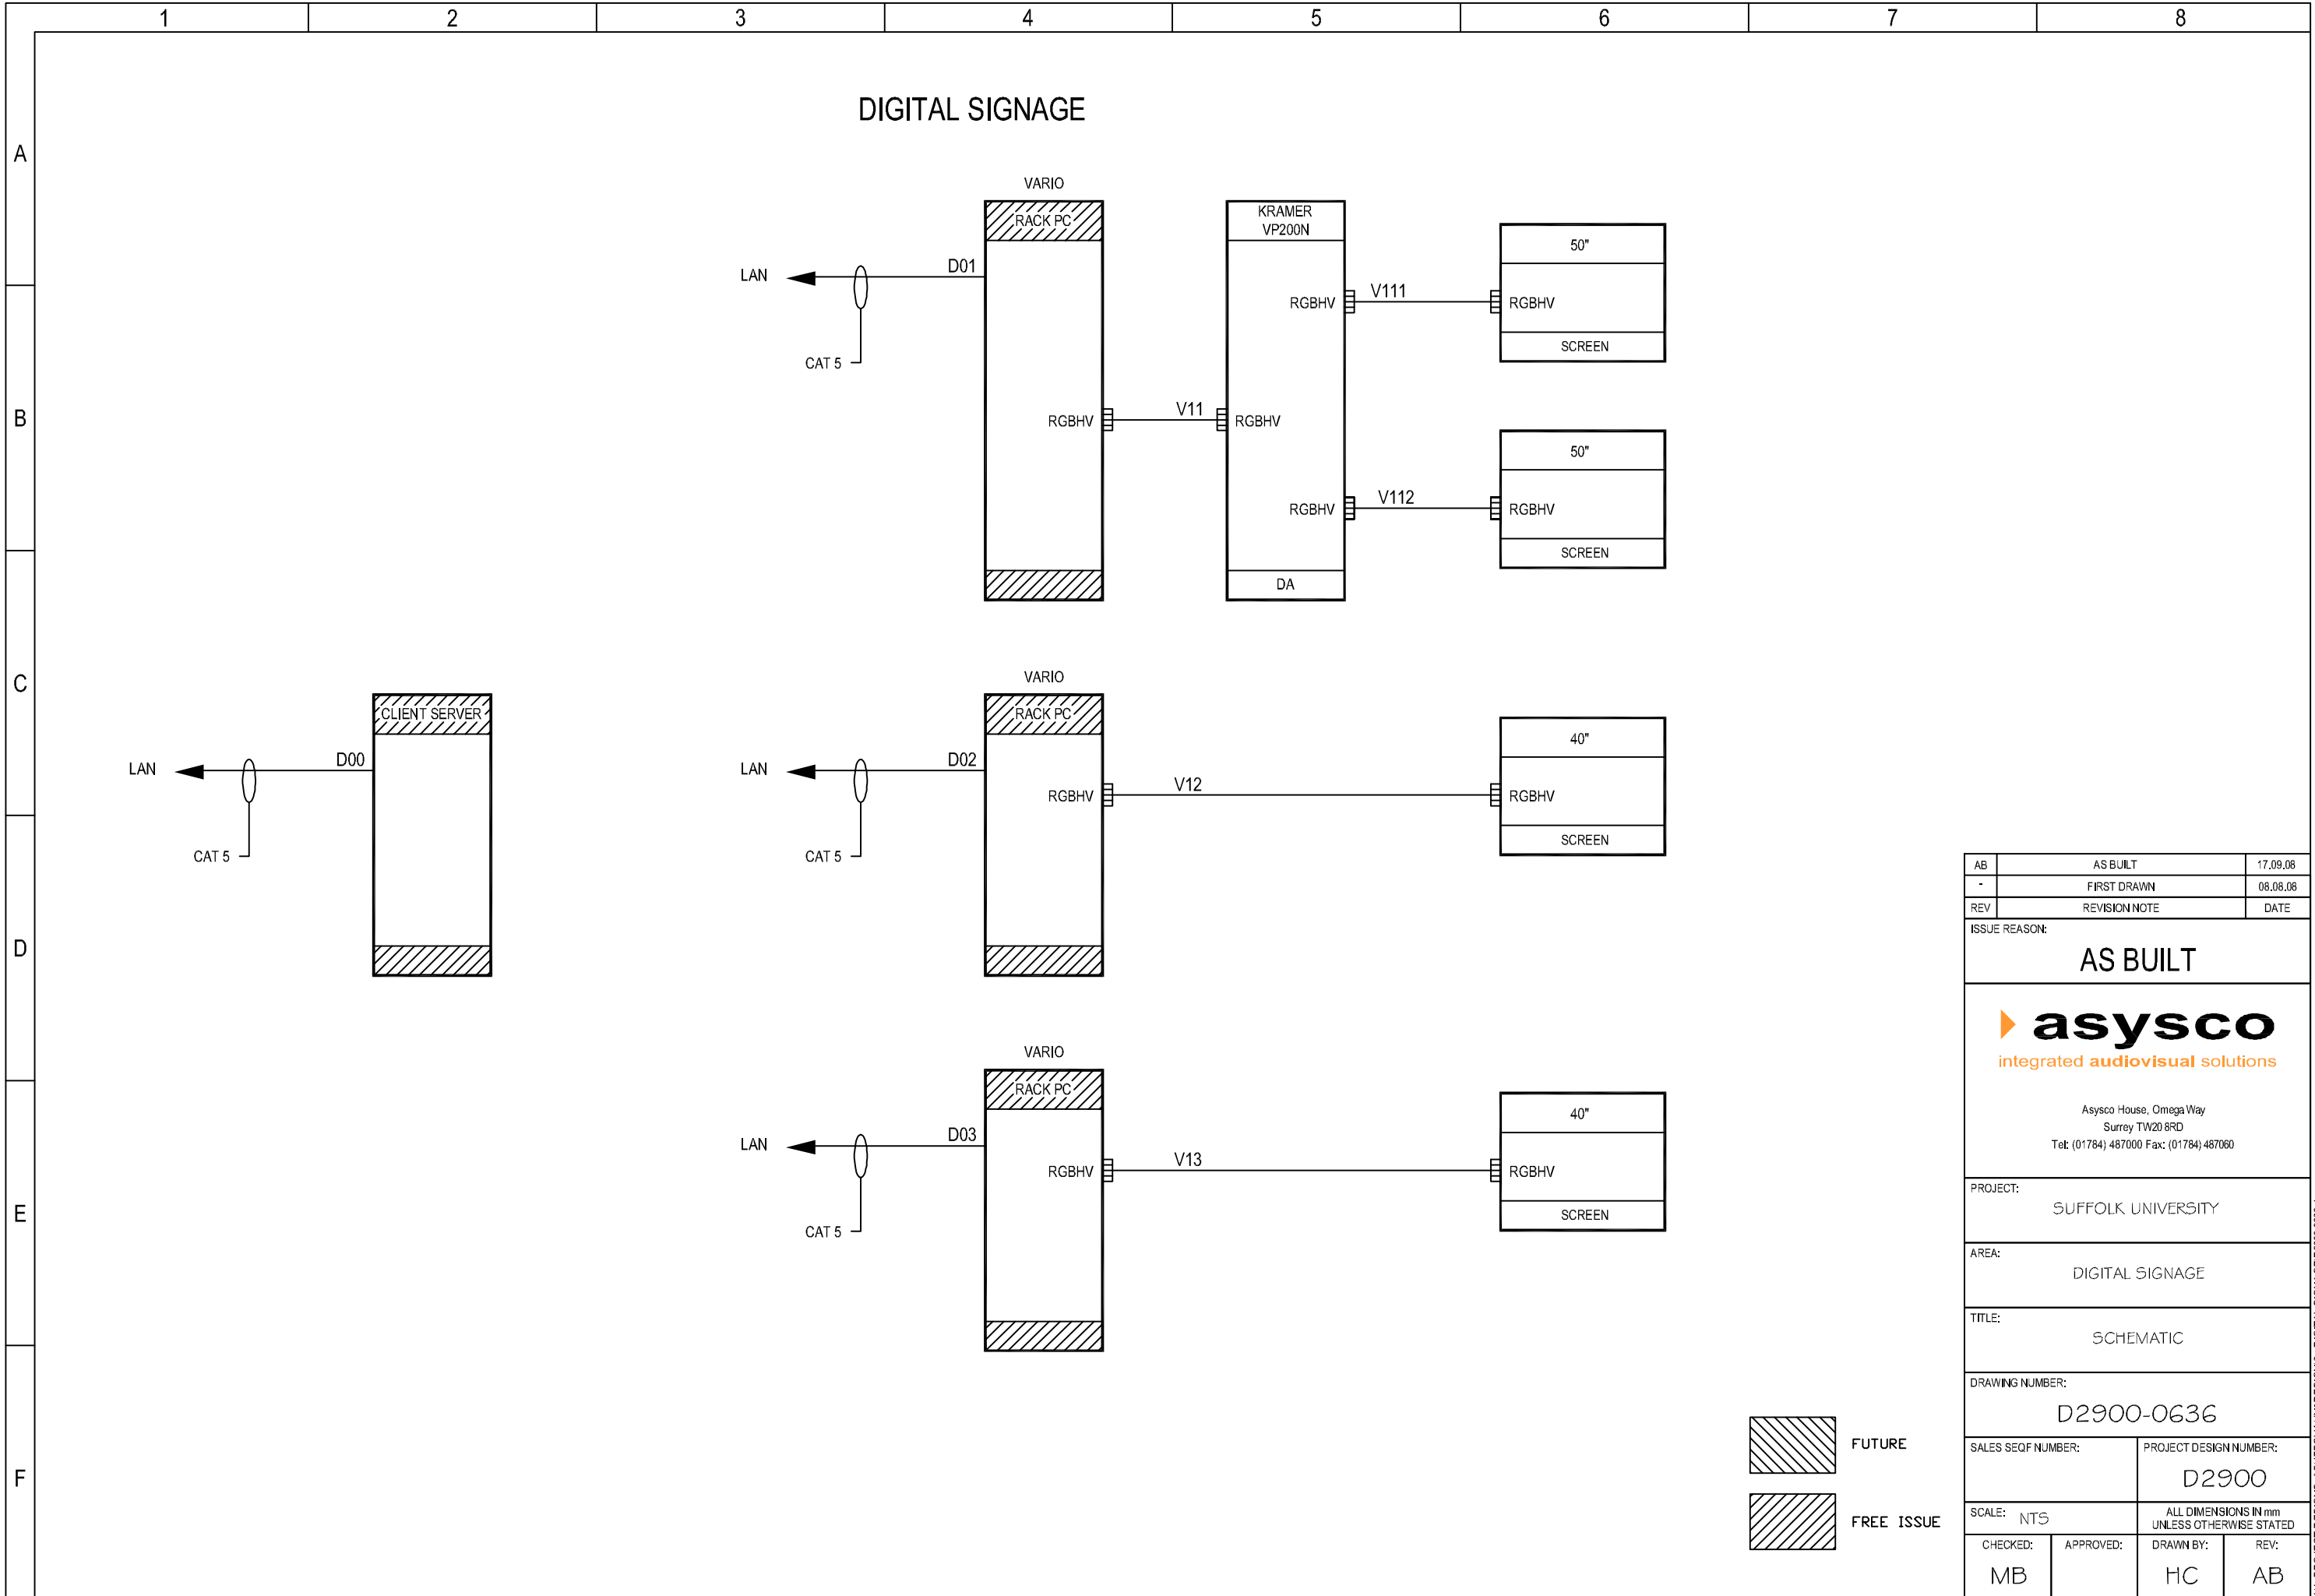

AB	AS BUILT	17.09.08
-	FIRST DRAWN	08.08.08
REV	REVISION NOTE	DATE

ISSUE REASON:  
**AS BUILT**

**asysco**  
 integrated audiovisual solutions

Asysco House, Omega Way  
 Surrey TW20 8RD  
 Tel: (01784) 487000 Fax: (01784) 487060

PROJECT: SUFFOLK UNIVERSITY	
AREA: DIGITAL SIGNAGE	
TITLE: SCHEMATIC	
DRAWING NUMBER: D2900-0636	
SALES SEQ# NUMBER:	PROJECT DESIGN NUMBER: D2900
SCALE: NT5	ALL DIMENSIONS IN mm UNLESS OTHERWISE STATED
CHECKED: MB	APPROVED: HC
DRAWN BY: AB	REV:

U:\PROJECT DESIGNS\SUFFOLK UNIDESIGN6 - DIGITAL SIGNAGE\D2900-0636.dwg