



THEATRE 1.02 (140 SEATS) RACK LAYOUT

EQUIPMENT ON TOP OF TEAMMATE VH PODIUM

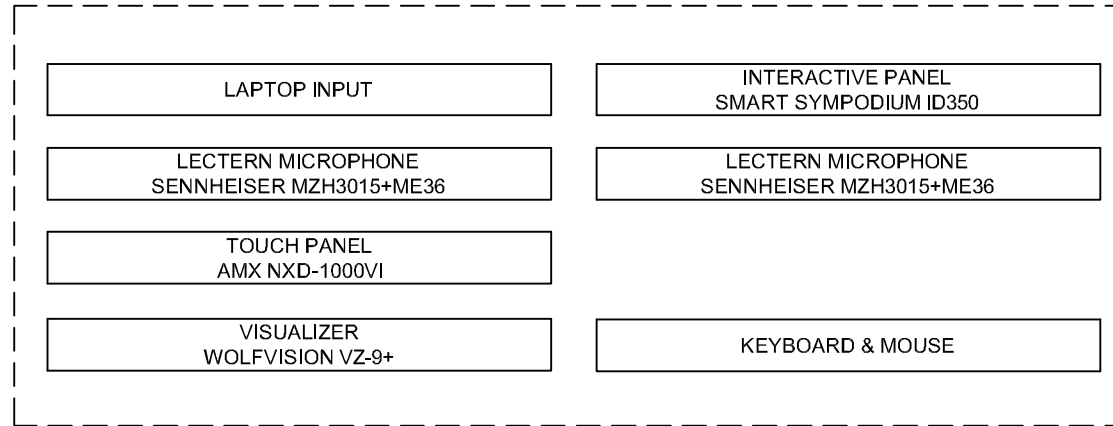


VH PODIUM RACK INFORMATION	
MAKE	TEAMMATE
MODEL	VH PODIUM
RACK TOP	
RACK SIDES	
CASTORS	
CABLE TYPES	ASYSKO STANDARD
RACK > RACK	
RACK > SITE	5m TAILS - MALE CONNECTORS

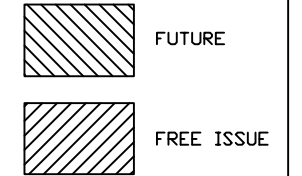

TEAMMATE BAY LEFT
TEAMMATE VH PODIUM RACK 14 U


TEAMMATE BAY RIGHT
TEAMMATE VH PODIUM RACK 14 U

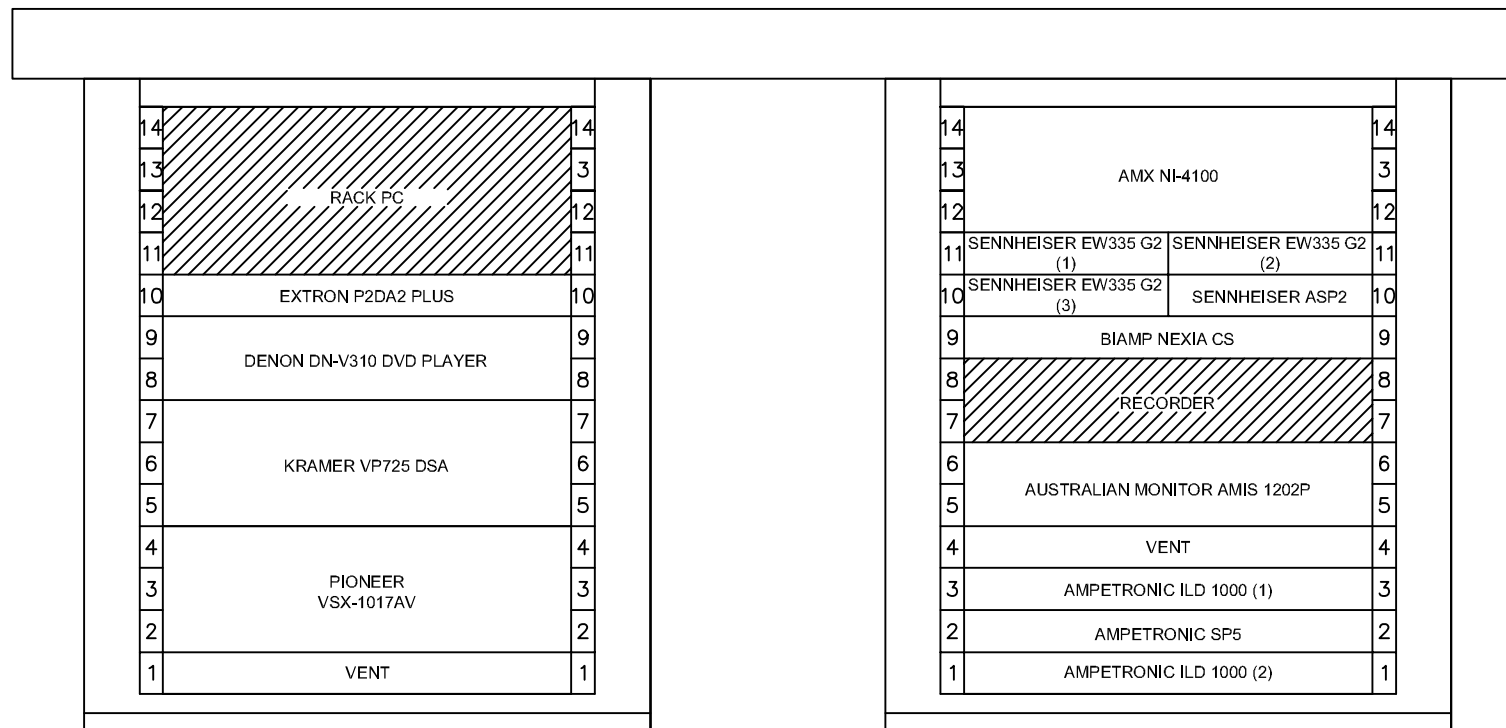

REV	REVISION NOTE	DATE
AB	AS BUILT	17.09.08
D	DENON AMP CHANGED TO PIONEER, AMX 3U	15.09.08
C	REDUCE 1RU OF AMPETRONIC ILD1000	09.09.08
B	ADD 1 RU SPACE FOR P2DA2, NO SPACE FOR RECORDER	19.08.08
A	CHANGED TAILS GENDER, TOUCHPANEL	31.7.08
-	FIRST DRAWN	16.07.08

ISSUE REASON:

AS BUILT



integrated audiovisual solutions

Asysco House, Omega Way
Surrey TW20 8RD
Tel: (01784) 487000 Fax: (01784) 487060

PROJECT: SUFFOLK UNIVERSITY

AREA: THEATRE 1.02 (140 SEATS)

TITLE: RACK LAYOUT

DRAWING NUMBER: D2900-0035

SALES SEQ NUMBER: PROJECT DESIGN NUMBER: D2900

SCALE: NTS ALL DIMENSIONS IN mm UNLESS OTHERWISE STATED

CHECKED: MB	APPROVED: HC	DRAWN BY: AB	REV:
-------------	--------------	--------------	------

U:\PROJECT DESIGNS\SUFFOLK UNIDESIGN\0 - THEATRE 1.02 (140 SEATS)\D2900-0035.dwg