


CONTROL SCHEMATIC

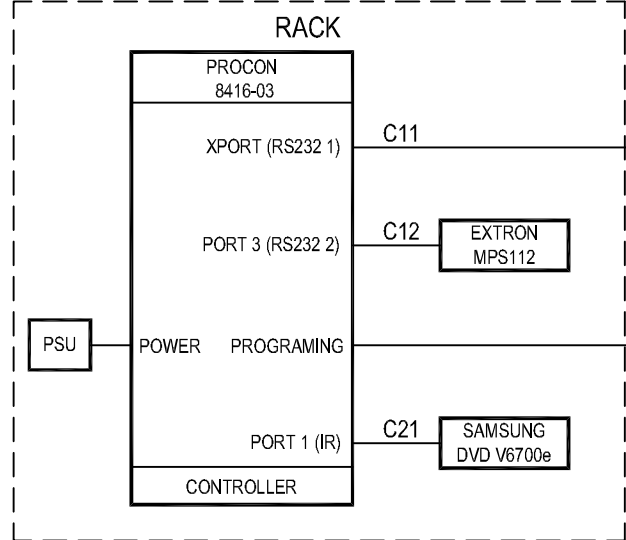


EQUIPMENT RACK INFORMATION

MAKE	TEAMMATE
MODEL	TRAINER
RACK TOP	
RACK SIDES	
CASTORS	
CABLE TYPES	ASYSCO STANDARD
RACK > SITE 2m TAILS - FEMALE CONNECTORS	
RACK > TROLLEY 8m TAILS - MALE CONNECTORS	

14 RU RACK TEAMMATE TRAINER0

14	SAMSUNG DVD/VHS V6700e	14
13	REVOLABS	13
12	BLANK	12
11	BIAMP NEXIA CS	11
10	EXTRON MPS112	10
9	RACK PC	9
8	SAMSUNG SERVO 300	8
7	AUSTRALIAN MONITOR AMIS 120P	7
6		6
5		5
4		4
3		3
2		2
1		1

- FUTURE
- FREE ISSUE

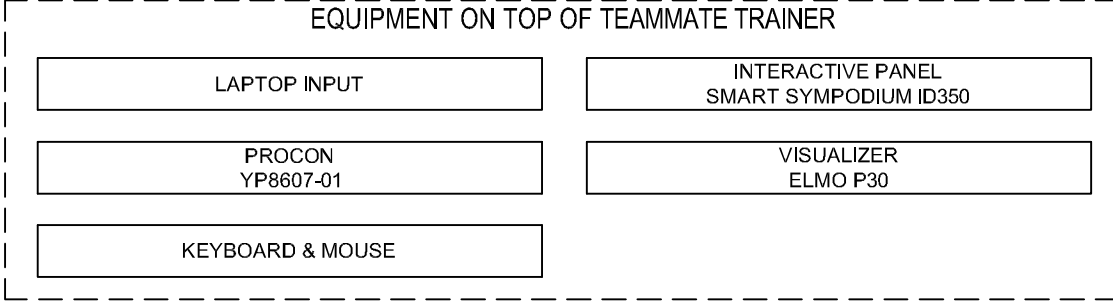

REV	REVISION NOTE	DATE
AB	AS BUILT	17.09.08
C	SCREEN CONTROL CHANGE	11.09.08
B	CABLE, CONNECTOR DETAILS ADDED	08.09.08
A	EXTRON MPS112 REPLACED KRAMER VP23C	05.09.08
-	FIRST DRAWN	08.08.08

ISSUE REASON:
AS BUILT

asysco
integrated audiovisual solutions

Asysco House, Omega Way
Surrey TW20 8RD
Tel: (01784) 487000 Fax: (01784) 487060

PROJECT: SUFFOLK UNIVERSITY

AREA: BOARDROOM

TITLE: VIDEO AUDIO CONTROL SCHEMATIC

DRAWING NUMBER: D2900-0536

SALES SEQ NUMBER: PROJECT DESIGN NUMBER: D2900

SCALE: NT5 ALL DIMENSIONS IN mm UNLESS OTHERWISE STATED

CHECKED:	APPROVED:	DRAWN BY:	REV:
MB	HC	AB	